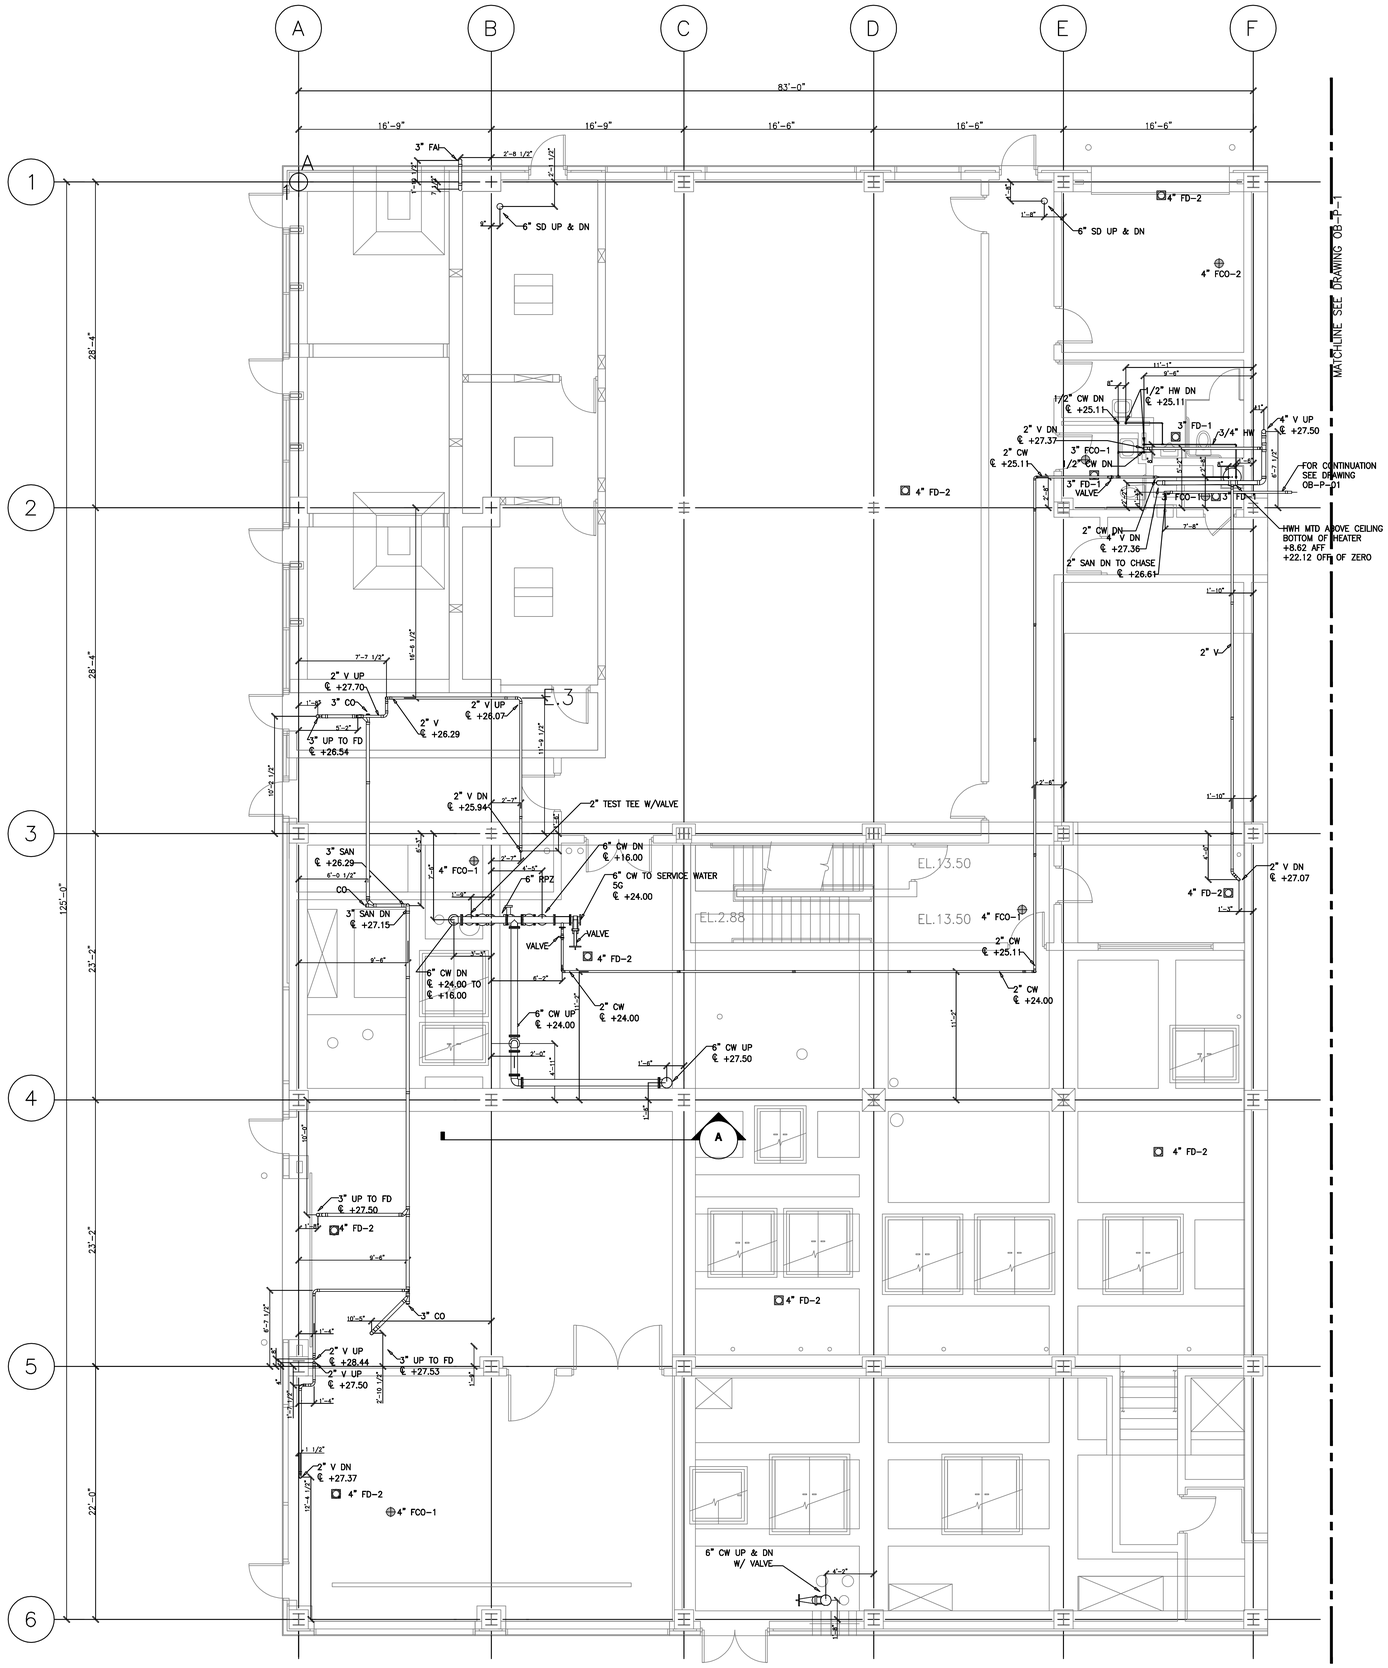

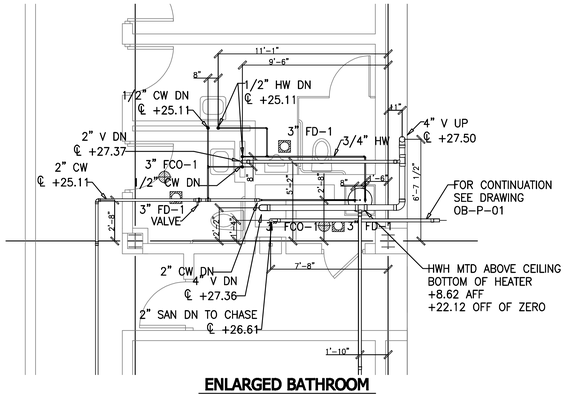

ENLARGED BATHROOM
Scale: 1/4"=1'-0"

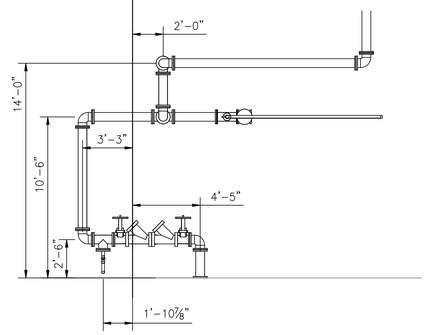

A SECTION A
Scale: 1/4"=1'-0"

NOTES

1.

NO	DR	REVISION	DATE
1	DM	AS PER REV C APRIL 2006	4/17/06
2	DM	AS PER REV D APRIL 2006	4/17/06

KEY PLAN

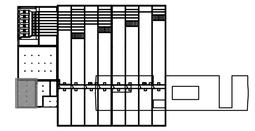

PROJECT NAME: WP-169 PAERDEGAT BASIN WATER QUALITY CONTRACT NO.: CSO-5P	
ITEM	PLUMBING LAYOUT DRAWINGS
SPEC. SECTION	15050
PAGE/PARAGRAPH	NA
CONTRACT DRAWING	3P-P-PB004
LOCATION	PUMP BACK BUILDING
SUBMITTAL NUMBER	15150-006-A
REVIEW CYCLE NUMBER	001
DRAWING NUMBER	PB-P-01
APPROVED BY	_
DATE	2-06-06

RECORD DRAWING OF WORK ASBUILT

MARCH 2009

DAWG DRAFTING

SCALE: 3/16"=1'-0"
DATE: 5/16/06

THIS DRAWING CREATED FROM CONTRACT DOCUMENTS DATED NOVEMBER 2004

FILE:
REVISED:

CITY OF NEW YORK
DEPARTMENT OF ENVIRONMENTAL PROTECTION
BUREAU OF ENVIRONMENTAL ENGINEERING
DIVISION OF FACILITIES DESIGN
WP-169 CITY WIDE CSO FACILITIES
PAERDEGAT BASIN WATER QUALITY FACILITY
CONTRACT CSO-5G - STRUCTURES AND EQUIPMENT

PUMP BACK BUILDING

GROUND FLOOR
PLUMBING PLAN

DRAWING NO.
PB-P-01